
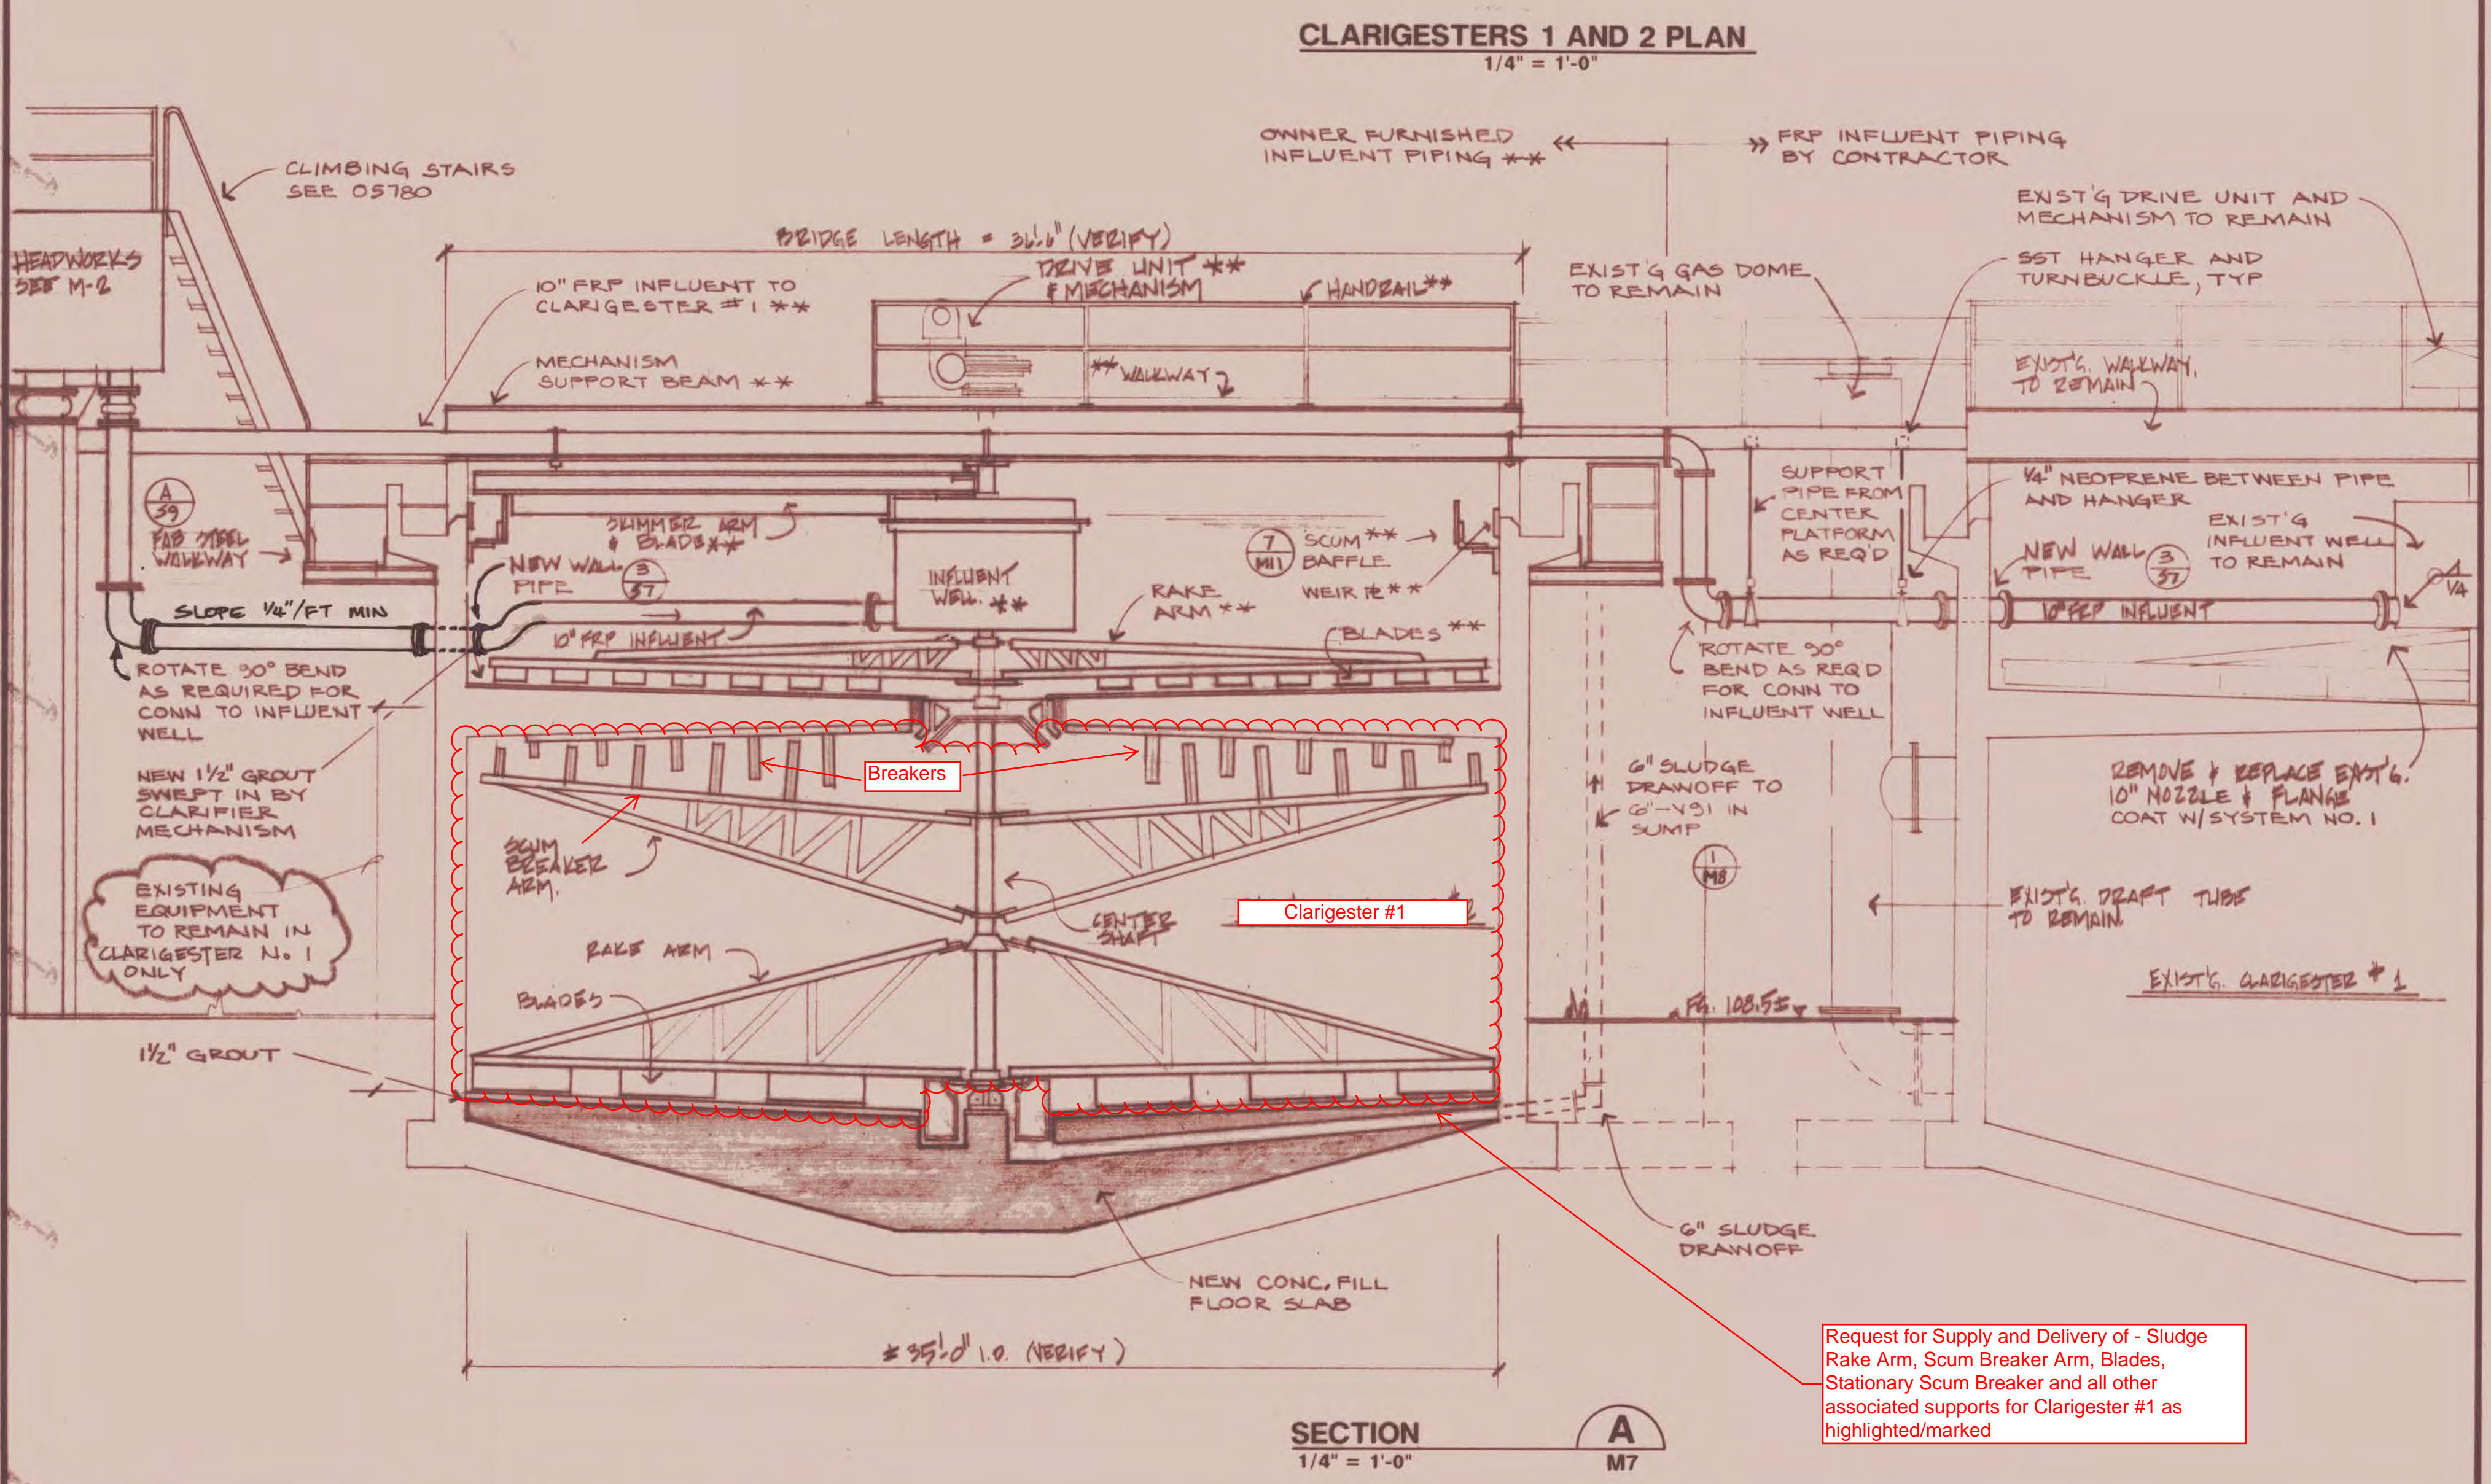


- NOTES:**
- ** DENOTES OWNER FURNISHED ITEMS TO BE INSTALLED THIS CONTRACT.
 - 10" FRP INFLUENT ** MOUNTED ON SUPPORT BEAMS ** VERIFY VERIFY DIMENSIONS w/ MANUFACTURER.
 - VERIFY DIMENSIONS OF OWNER-FURNISHED CLARIGESTER EQUIPMENT. REFER TO MANUFACTURER SHOP DRAWINGS.
 - EXISTING CLARIGESTER 2 TO BE REMOVED FROM SERVICE BY OWNER AND CLEANED AND REHABILITATED BY CONTRACTOR. SEE SECTION 01300.
 - EXISTING CLARIGESTER 1 TO BE REMOVED FROM SERVICE BY OWNER AND CLEANED BY CONTRACTOR. REHABILITATE ONLY AS SHOWN.

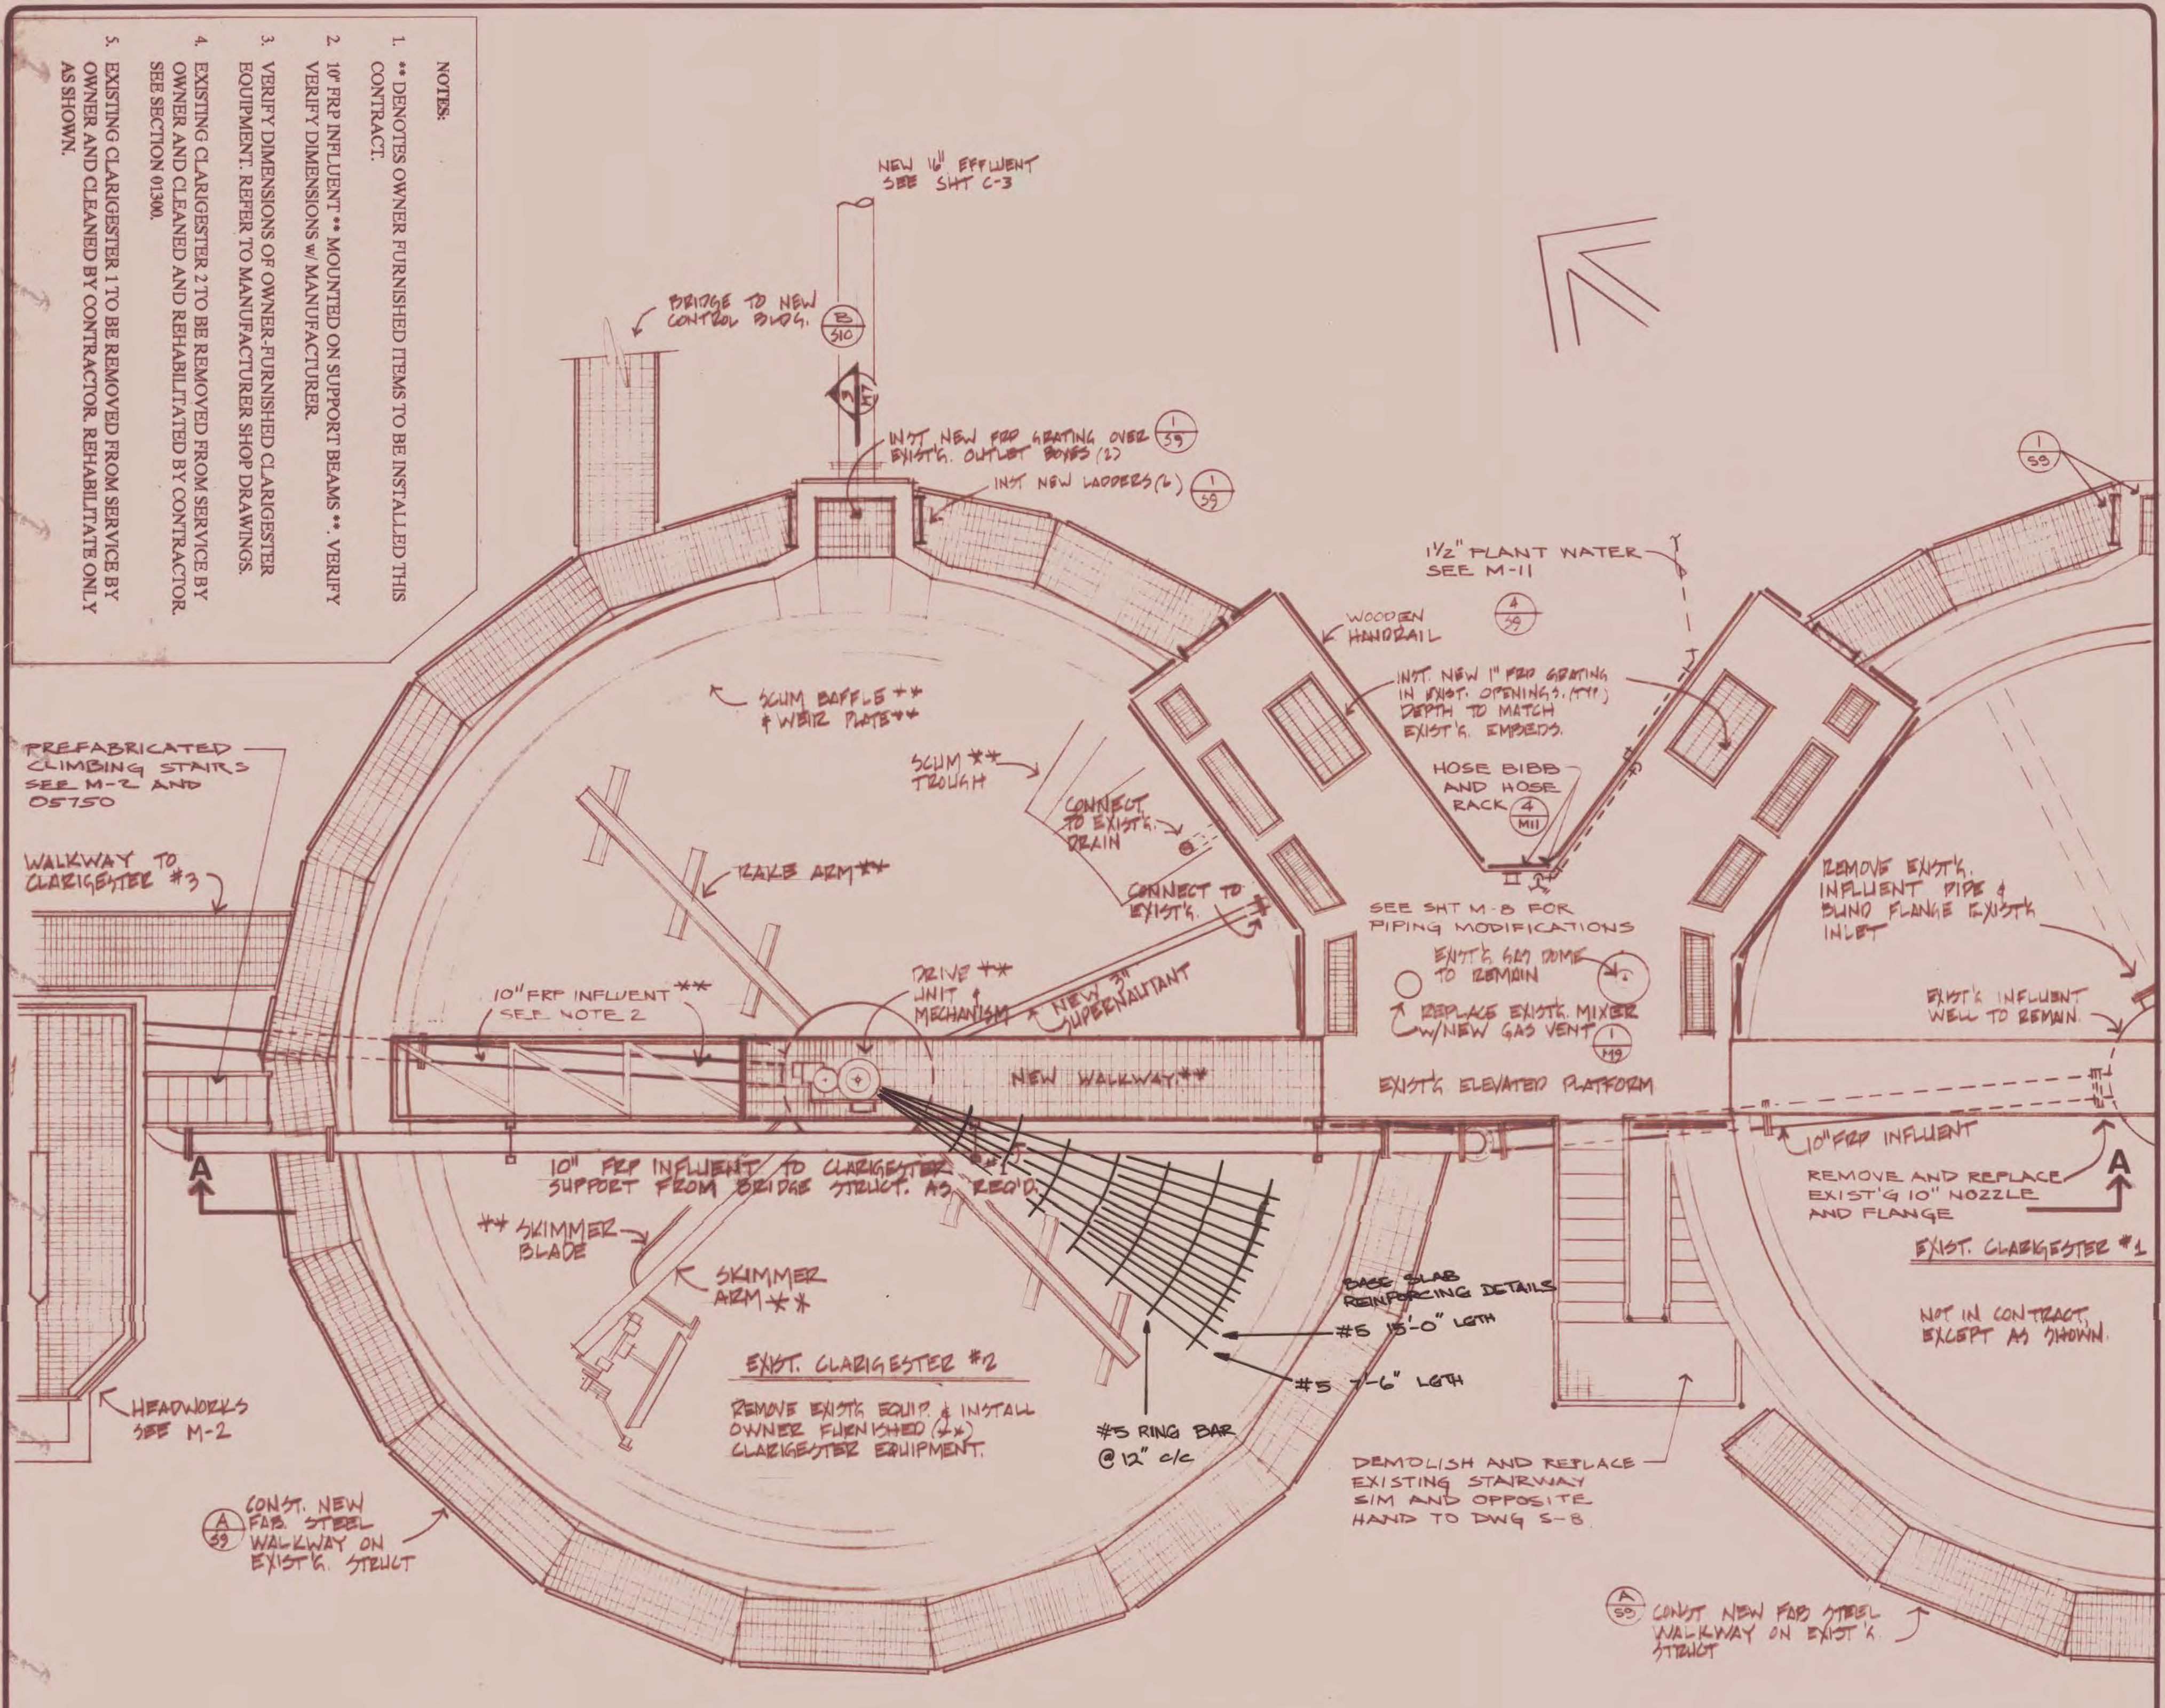

Request for Supply and Delivery of - Sludge Rake Arm, Scum Breaker Arm, Blades, Stationary Scum Breaker and all other associated supports for Clarigester #1 as highlighted/arked

39 OF 57 SHEET JOB NUMBER 1165.300.0	DRAWING NO. M-7	AMERICAN SAMOA POWER AUTHORITY ASPA-WASTEWATER DIVISION UTULEI WASTEWATER TREATMENT PLANT EXPANSION		WE WESTECH ENGINEERING, INC. CONSULTING ENGINEERS & PLANNERS 3421 25th ST. S.E., SALEM, OREGON (503) 585-2474 13500 72nd AVE. S.W., PORTLAND, OREGON (503) 684-9226	REGISTERED PROFESSIONAL ENGINEER JOHN L. YARNALL 6/19/92	SCALE HORIZ. NOTED VERT. —	DSN. JY 2 8-8-94 ASBUILT BY MCCONNELL DOWELL LTD SWS DRN. JG 1 11/4/92 REV PER ADDM # 4 JY. CKD. JY/DC NO. DATE DESCRIPTION BY DATE: JUN 92 REVISIONS	
		EXISTING CLARIGESTERS 1 & 2 - PLAN AND SECTION						