


CLARIGESTERS 3 AND 4 PLAN
1/4" = 1'-0"

- NOTES:**
- ** DENOTES OWNER FURNISHED ITEMS TO INSTALLED IN THIS CONTRACT.
 - CLARIGESTER #4 SHALL BE SIMILAR TO CLARIGESTER #3 AS SHOWN.
 - VERIFY DIMENSIONS OF OWNER-FURNISHED CLARIGESTER EQUIPMENT.
 - VERIFY DIMENSIONS OF OWNER-FURNISHED INFLUENT PIPING PRIOR TO INSTALLATION.

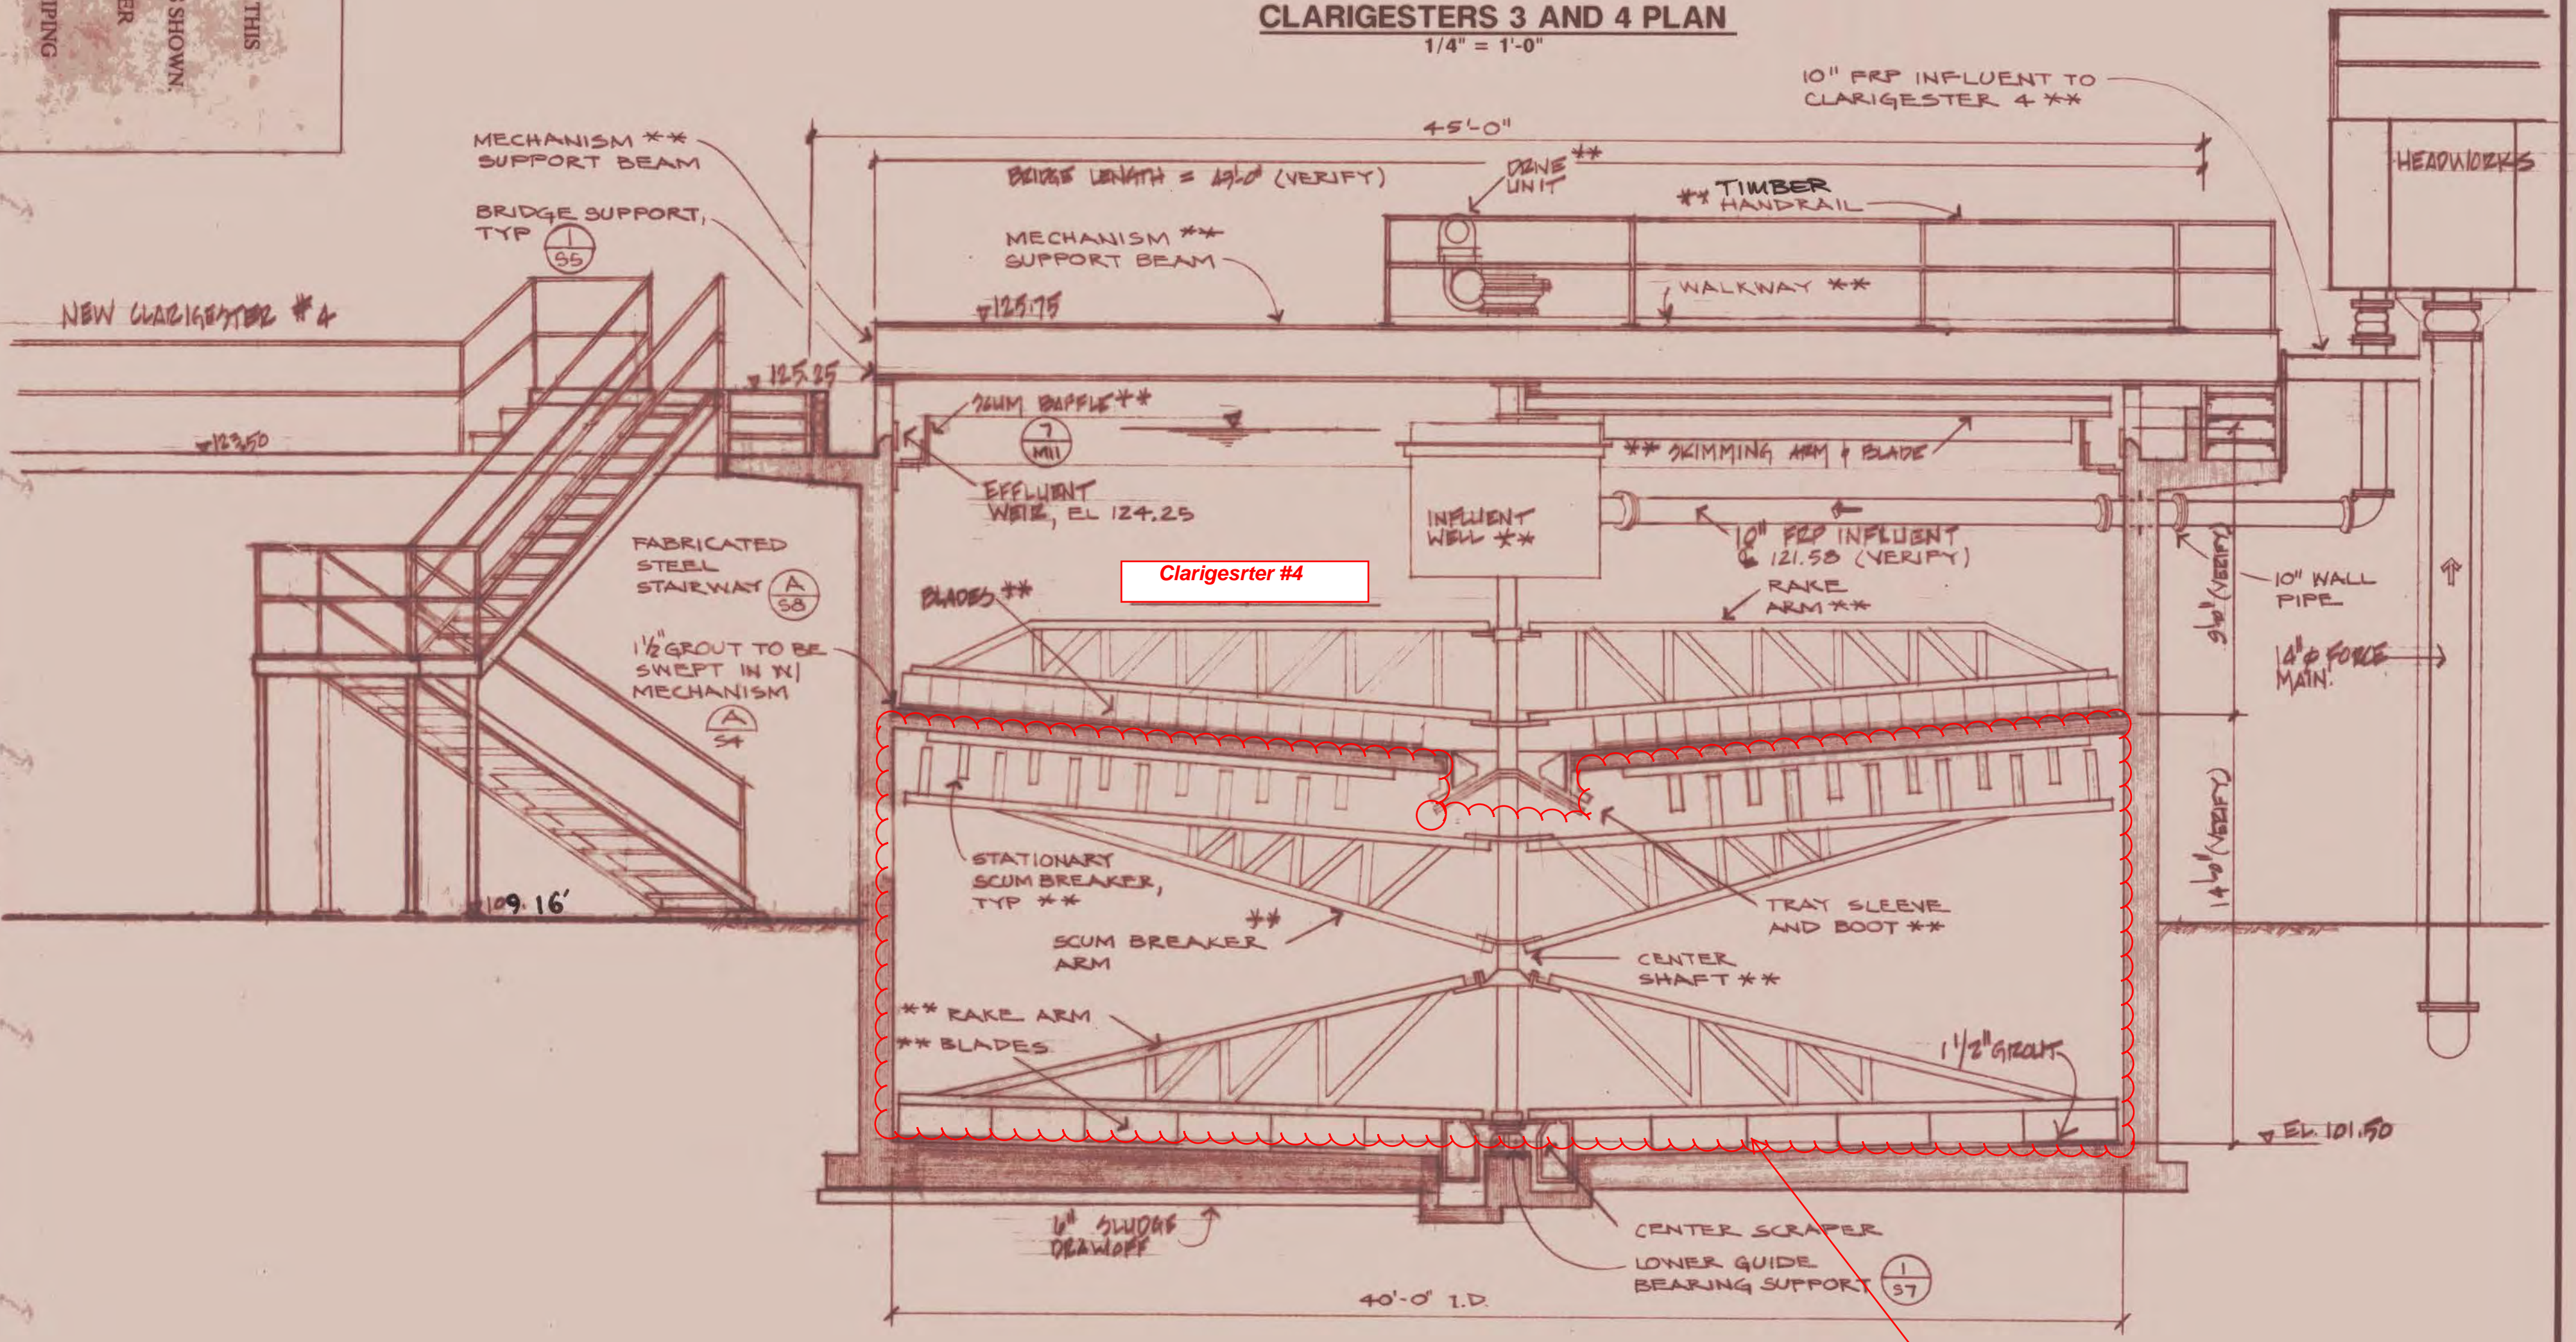

SECTION A
1/4" = 1'-0" M4

Request For Quotation to Supply and Delivery
- Digester Scum Breaker Arm, Digester
Sludge Rake Arm, Blades, Stationary Scum
Breaker and all associated supports for
Clarigester #4

AMERICAN SAMOA POWER AUTHORITY ASPA-WASTEWATER DIVISION UTULEI WASTEWATER TREATMENT PLANT EXPANSION NEW CLARIGESTERS 3 AND 4 - PLAN AND SECTION	WESTECH ENGINEERING, INC. CONSULTING ENGINEERS & PLANNERS 3421 25th ST. S.E., SALEM, OREGON (503) 585-2474 13500 72nd AVE. S.W., PORTLAND, OREGON (503) 684-9226	SCALE HORIZ. NOTED VERT.	DSN. JY DRN. JG CKD. JY/DC DATE: JUN 92	NO. 8-8-94 DATE	ASBUILT BY MCCONNELL DOWELL LTD DESCRIPTION REVISIONS	BY SWS
		DRAWING NO. M-4	SHEET 36 OF 57	JOB NUMBER 1165.300.0		